


MADE IN AMERICA
 BY AMP INCORPORATED, ALL RIGHTS RESERVED
 UNPUBLISHED COPYRIGHT
 REPRODUCED OR TRANSMITTED IN ANY FORM OR BY ANY MEANS WITHOUT WRITTEN PERMISSION OF AMP INCORPORATED.

REVISIONS			
LTR	DESCRIPTION	DATE	APPROVED
O	NPS 74-0337	PM 6-4-74	<i>JM</i>
A	REVISED ECN P-7424	PM 12/20/74	L.D.
B	INACT P9268	12-13-82	<i>JM</i>
C	OBS -4 REV G 2589	BT 10-12-87	<i>JM</i>

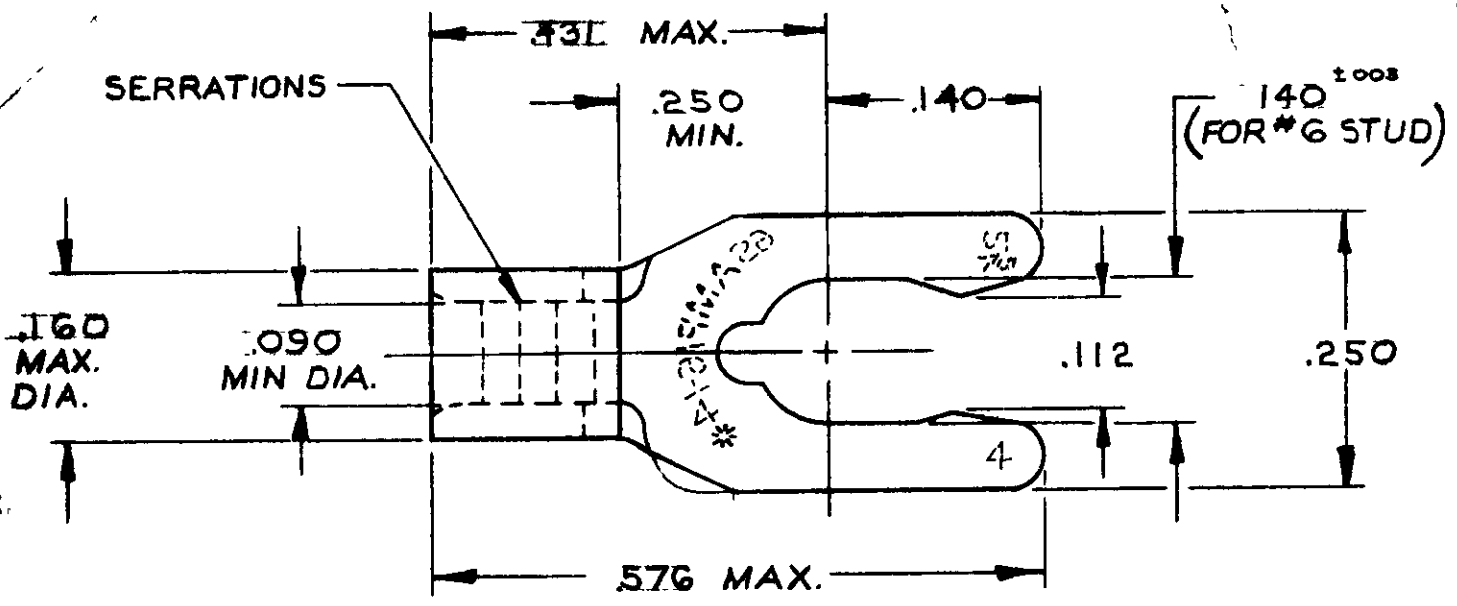

INACTIVE
 P9268
 JM
 12-13-82

~~ENGINEERING CONTROLLED~~

OBSOLETE ~~53010-4~~ 53010-3

PART NO ON TAPE PART NO

UNLESS OTHERWISE SPECIFIED DIMENSIONS ARE IN INCHES
 TOLERANCES ON:
 DECIMALS ±.008
 FRACTIONS ±.005

CONTRACT NO. H
 DR. Phil Monaghan 5-30-74
 CHK. *JM* 6-4-74
 APPD. Les Abel 6-5-74
 REL. Phil Monaghan 8-5-74
 DSGN APPD. *JL Brown* 6-4-74
 OTHER APPD.



AMP INCORPORATED
 HARRISBURG, PENNSYLVANIA

NAME
 WIRE TERMINAL BUDGET - SPRING SPADE (SHORT)
 WIRE SIZE: 16-14

MATERIAL
 PHOSPHOR BRONZE
 (MIL-C-576)
 TIN PLATED
 (MIL-T-1072)

SIZE A CODE IDENT NO. 00779 NUMBER 53010

SCALE N.T.S. SHEET 1 OF 1